


NOTES:
1. THE INFORMATION SHOWN HEREON WAS PROVIDED BY QUALITY ASSURANCE PERSONNEL.



AS-BUILT LOCATIONS OF THE
GEOSYNTHETIC CLAY LINER
AT THE SAUGET AREA 1
TSCA LANDFILL, CAHOKIA
ILLINOIS

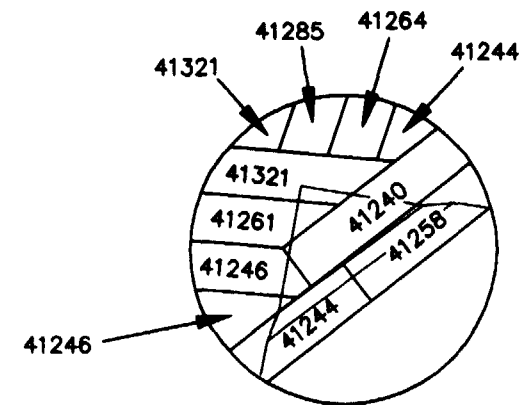


INSET - DOUBLE
LAYER OF GEOSYNTHETIC
CLAY LINER IN SUMP AREA

LEGEND

29682 = ROLL DESIGNATION

**ENVIRONMENTAL
PRECISION ASSOCIATES
INC.**

ENVIRONMENTAL LAND AND CONSTRUCTION SURVEY SERVICES
105 PECAN STREET
P.O. BOX 514
TROY, ALABAMA 36061
TEL \ FAX (334) 807-0028
MOBILE: (334) 670-8232
PAGER: (800) 443-7243
Bf 012878

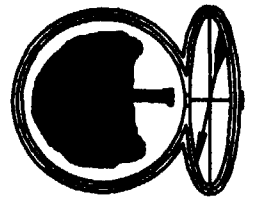

AS-BUILT LOCATIONS OF THE
GEOSYNTHETIC CLAY LINER
AT THE SAUGET AREA 1
TSCA LANDFILL, CAHOKIA
ILLINOIS

DRAWN BY: W.H.S.

DRAWN BY: W.H.S.
CHECKED BY: W.H.S.

SCALE: 1" = 60'

DRAWING DATE: 08/15/01
SURVEY DATE: 08/15/01

CLIENT FILE: 01-500

DRAWING FILE: SOSLINER

F.L.D. BK.: ELECTRONIC

PAGE(S):